

REVISIONS

10/03/13 - TOC Comments
06/20/14 - Pump Room Revision

PROJECT DATA

Project No: 13-013
File Name: CE-081914-CONDO-PLAT
TOWN OF OCEAN CITY
WORCESTER COUNTY, MARYLAND
DATE: 10/21/14
SCALE:
1" = 10'


CONDOMINIUM
PLAT

PREPARED FOR:
THE VIEW
CONDOMINIUM
OCEAN CITY, MD

Atlantic Planning &
Development & Design, Inc.
5700 Coastal Hwy, Suite 306
Ocean City, MD 21842
Ph: 443-664-2665

**VISTA
DESIGN, INC.**
Landscape Architects, Land Planning Consultants, Engineers, and Surveyors
11634 Worcester Hwy, Sharnett, MD 21862
ph: 410-332-3874 fax: 410-332-3875 email: info@vistadesigninc.com

2 OF 8

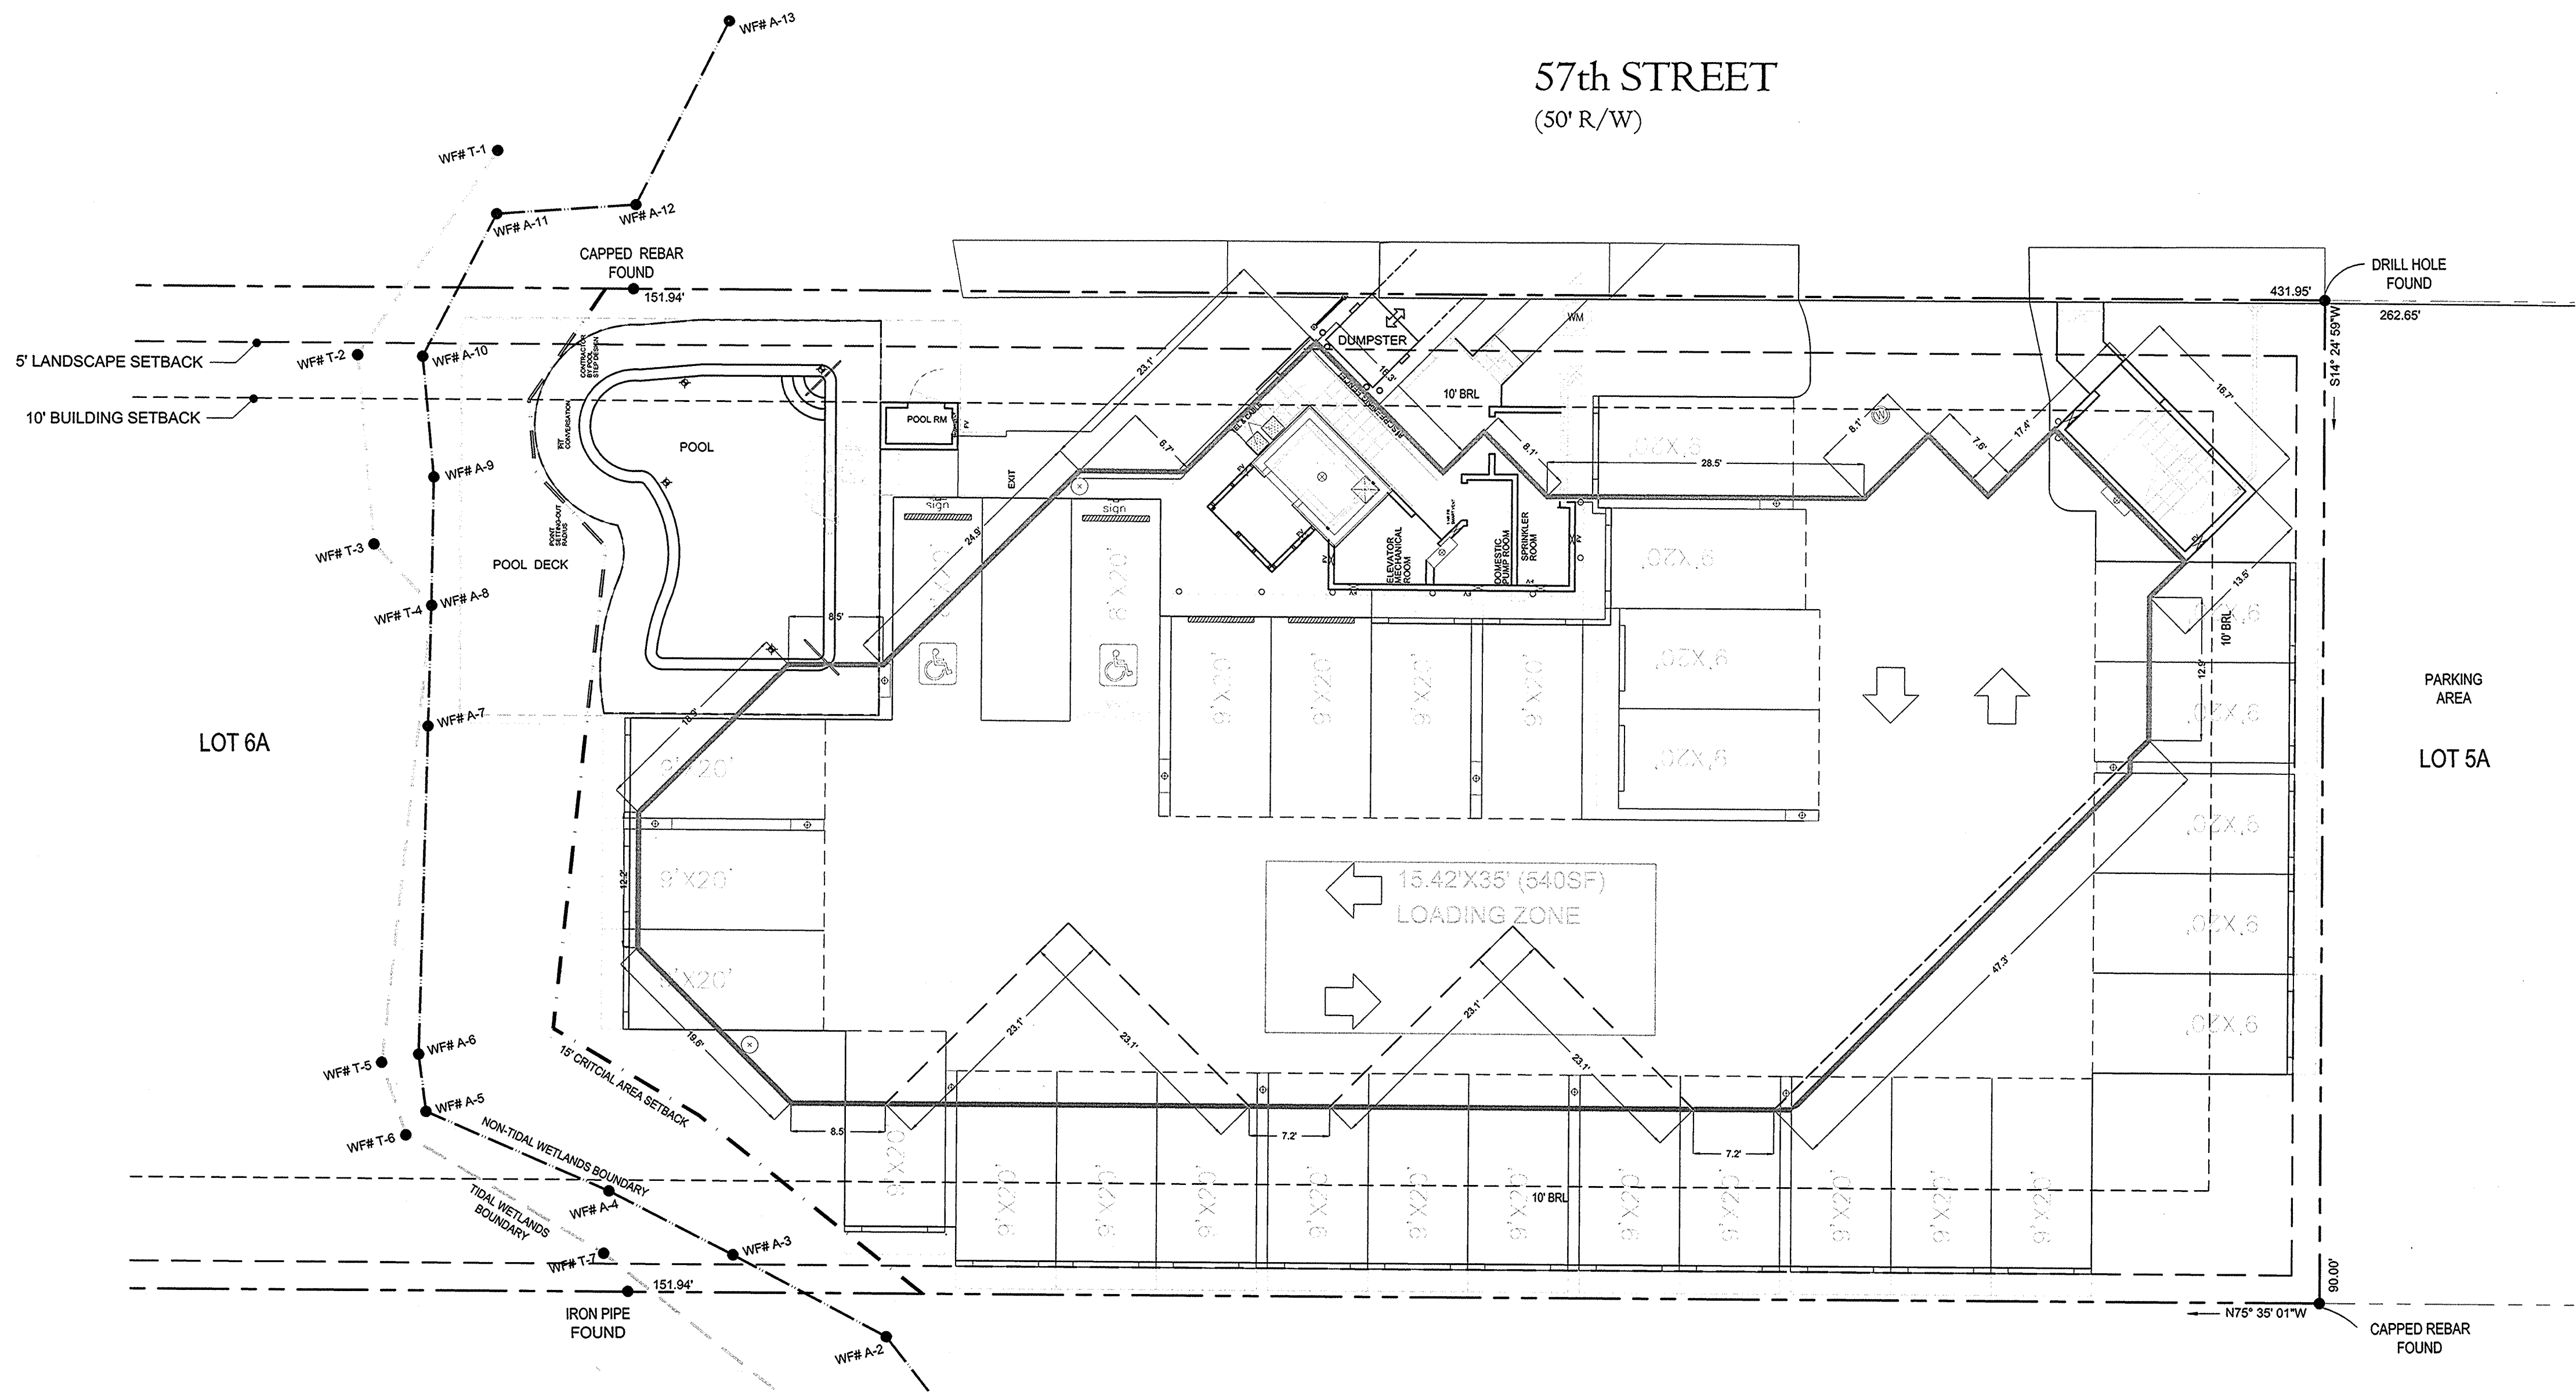

SURVEYOR'S CERTIFICATE:

I CERTIFY THAT THE REQUIREMENTS OF SECTION 11-105 OF THE REAL PROPERTY VOLUME OF ANNOTATED CODE OF MARYLAND (LATEST EDITION), CONCERNING THE MAKING OF THIS PLAT AND THE SETTING OF MARKERS HAVE BEEN COMPLIED WITH AND THAT PLAT, TOGETHER WITH THE APPLICABLE WORDING OF THE DECLARATION, IS A CORRECT REPRESENTATION OF THE CONDOMINIUM DESCRIBED, AND THE IDENTIFICATION AND LOCATION OF EACH UNIT AND THE COMMON ELEMENTS, AS CONSTRUCTED, CAN BE DETERMINED FROM THEM.

DOMINIC AGRESTA DATE:
MD LICENSE #21407

GRAPHIC SCALE
SCALE: 1" = 5 ft.

NOTE:
This drawing, specifications, and work produced by Vista Design, Inc. (VDI) for this project are instruments of service for this project only, and remain the copyrighted property of VDI. Reproduction of any of the instruments of service of VDI by the Client or assignees without the written permission of VDI will be at the Client's risk and be a violation of the copyright laws of the United States of America and the respective state within which the work was completed.

NOTE:
This Drawing does not include necessary components for construction safety. All construction must be done in compliance with the occupational safety and health act of 1970 and all rules and regulations thereto appurtenant.

P.207894 MSA 81257-8845-2